

REPUBLIC OF THE PHILIPPINES
DEPARTMENT OF PUBLIC WORKS & HIGHWAYS
OFFICE OF THE BUILDING OFFICIAL


CEBU CITY

RECOMMENDING APPROVAL:

HEAD, ARCHITECTURAL SECTIONDATE:

APPROVED:


BUILDING OFFICIALDATE:

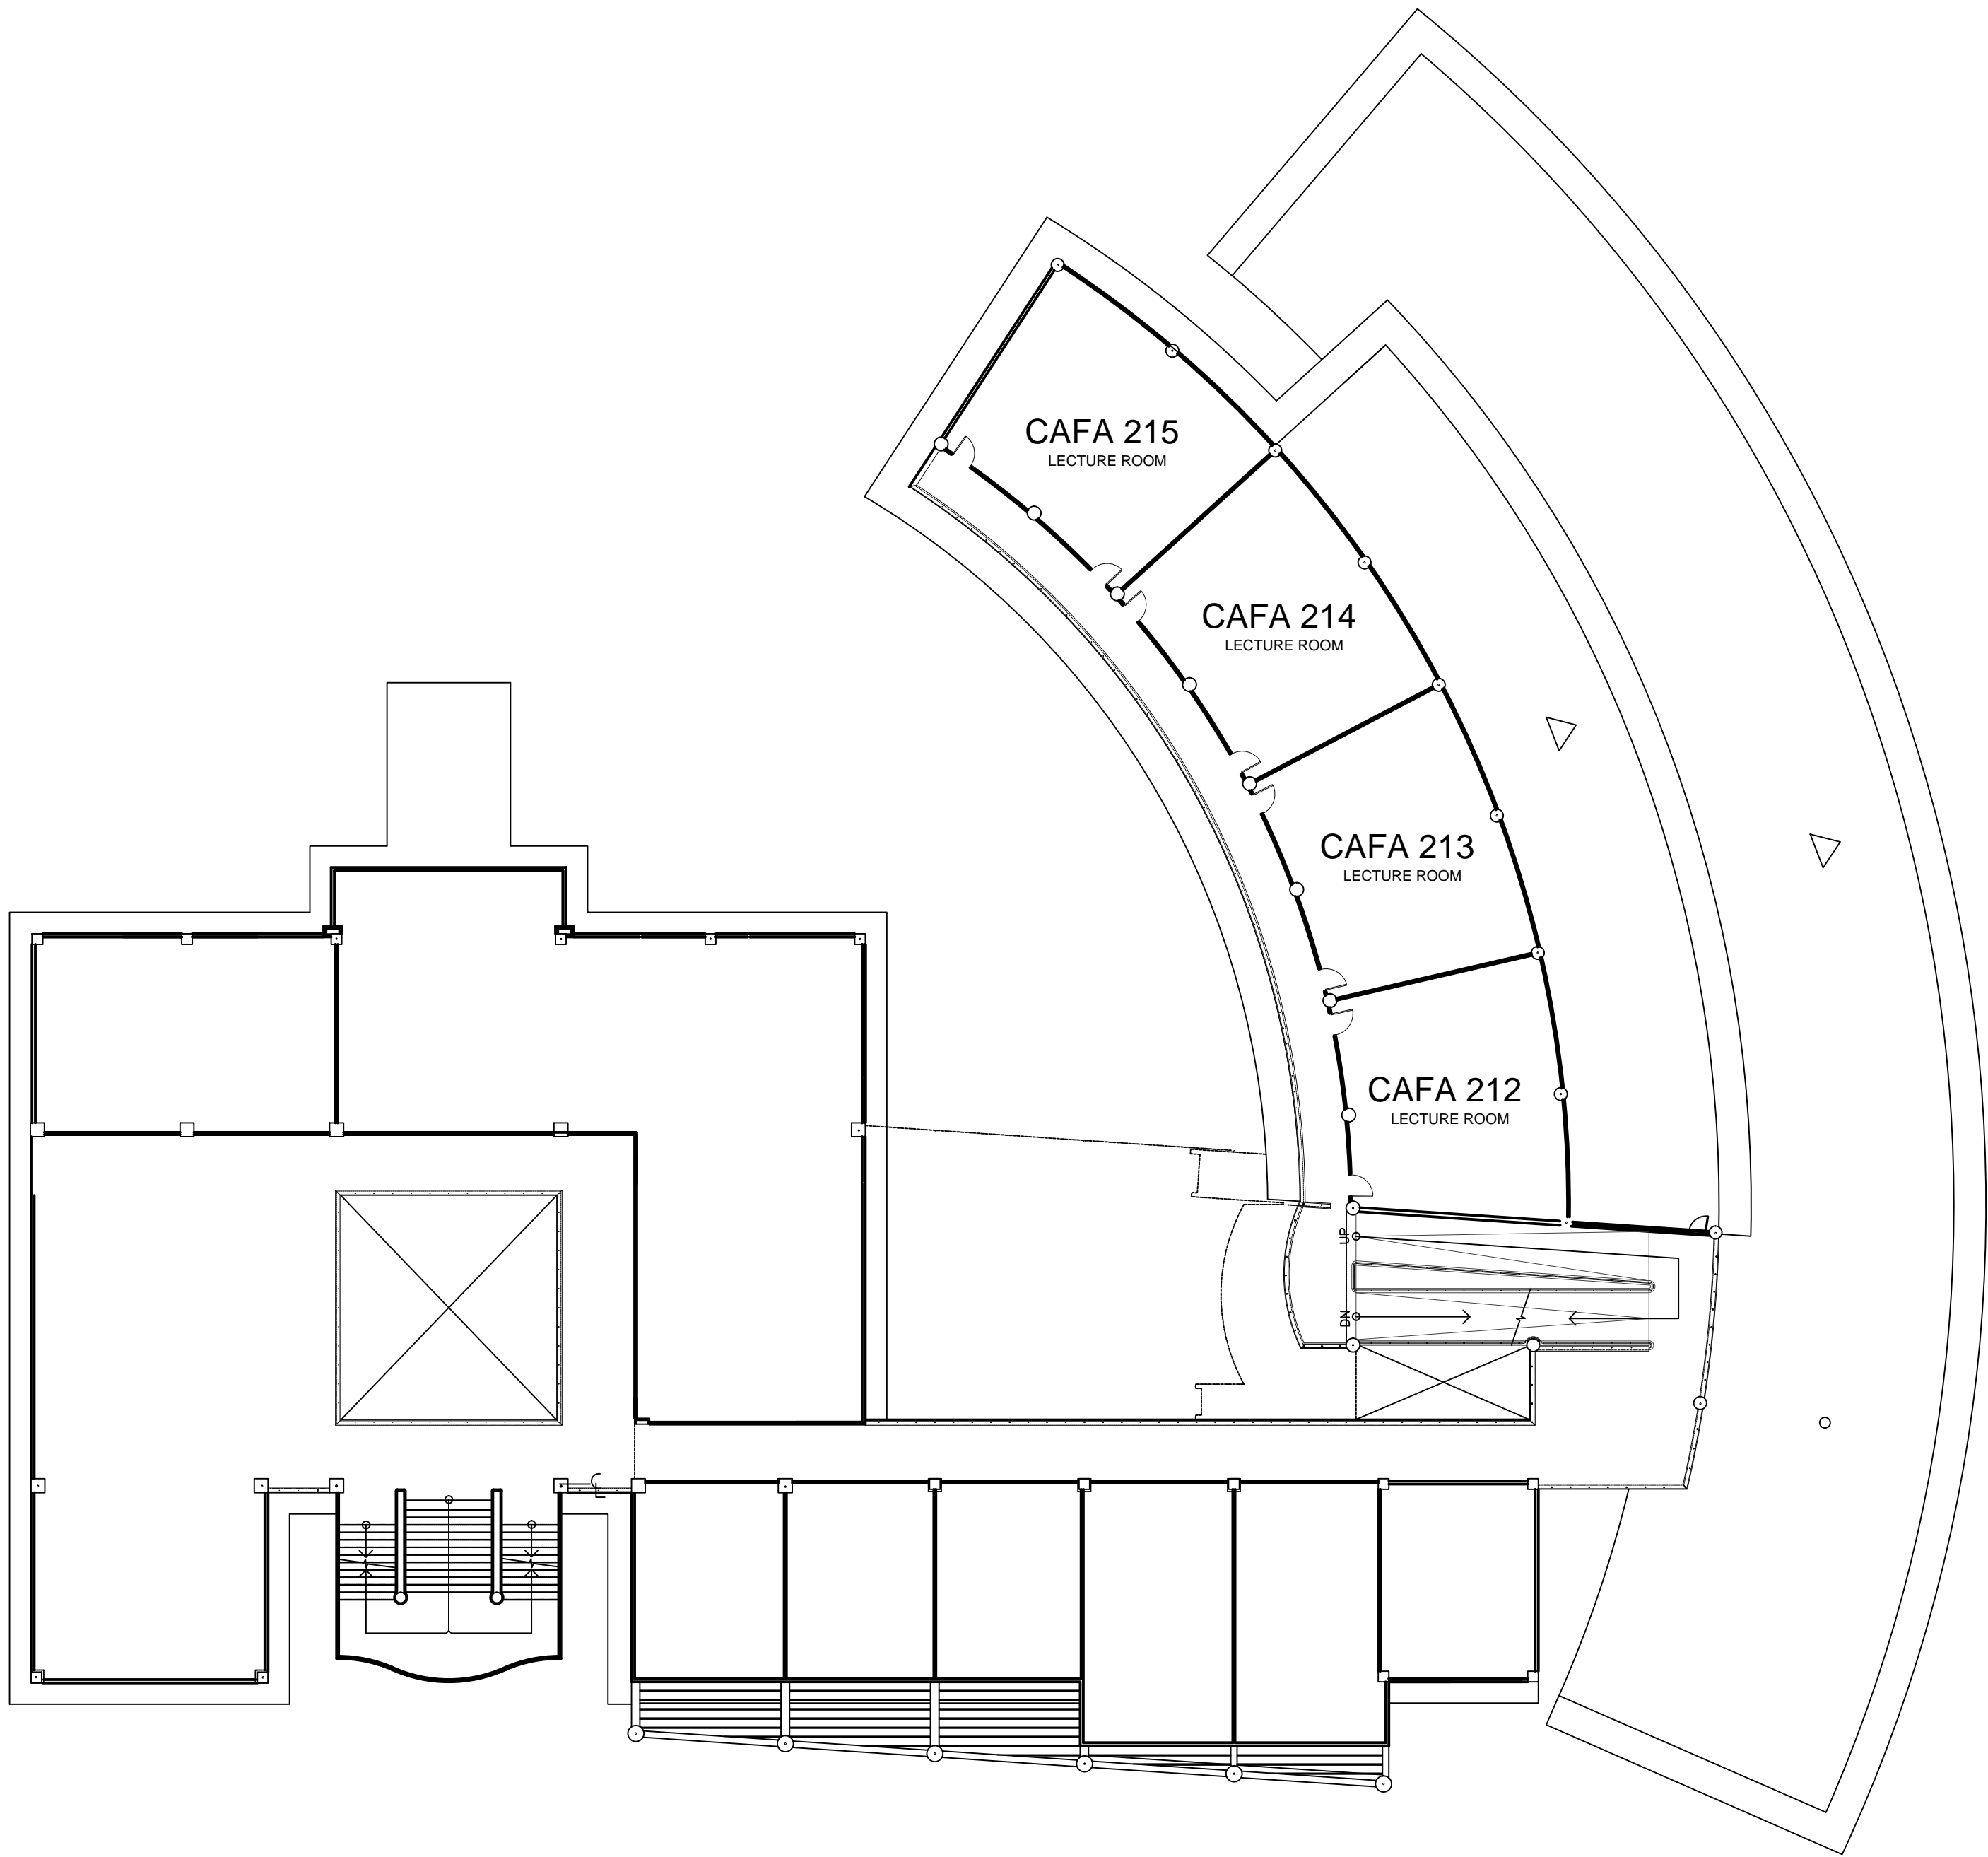

01
- 02

MEZZANINE FLOOR PLAN


SCALE 1: 250M

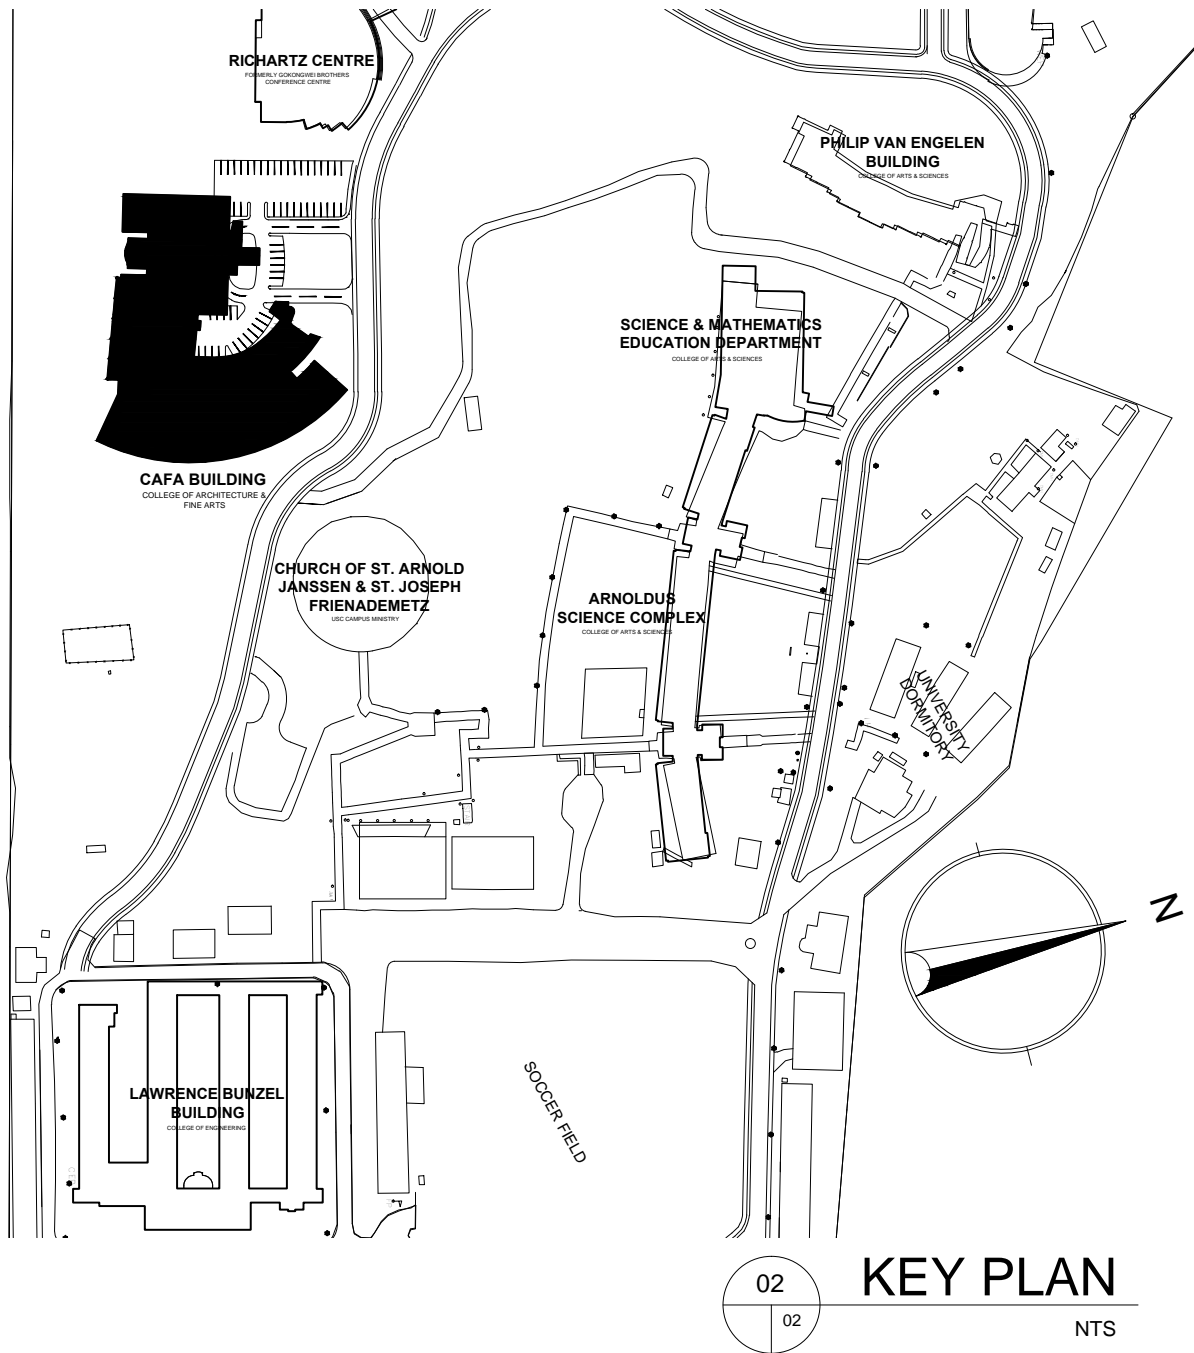

02
02

KEY PLAN

NTS

 <div>I D O</div>	ELLIS A. PUERTO ARCHITECT		R.A. 9266 ARTICLE IV SEC. 33 DRAWINGS AND SPECIFICATIONS AND OTHER CONTRACT DOCUMENTS DULY SIGNED, STAMPED OR SEALED, AS INSTRUMENTS OF SERVICE, ARE THE INTELLECTUAL PROPERTY AND DOCUMENTS OF THE ARCHITECT, WHETHER THE OBJECT FOR WHICH THEY ARE MADE IS EXECUTED OR NOT. IT SHALL BE UNLAWFUL FOR ANY PERSON TO DUPLICATE OR TO MAKE COPIES OF SAID DOCUMENTS FOR USE IN THE REPETITION OF AND FOR OTHER PROJECTS OR BUILDINGS, WHETHER EXECUTED PARTLY OR IN WHOLE, WITHOUT THE WRITTEN CONSENT OF ARCHITECT OR AUTHOR OF SAID DOCUMENTS.	PROJECT TITLE:	AS BUILT PLANS OF COLLEGE OF ARCHITECTURE AND FINE ARTS BUILDING	SHEET CONTENTS		REVISIONS		APPROVED:	CONTRACT DRAWING NO.
	PRC NO. :	VALIDITY :		OWNER:	UNIVERSITY OF SAN CARLOS	01 AS SHOWN	<div>1</div>		FR. DIONISIO M. MIRANDA, SVD PRESIDENT	A-000 A-000	
	IAPOA NO. :	O.R. NO. : DATE:		LOCATION:	NASIPIT TALAMBAN, CEBU CITY	ENCODED BY: VILLANUEVA, IL JEAN R.	<div>2</div>				
	PTR NO. :	DATE :				REVISED BY:	<div>3</div>				
	PLACE :	TIN :									
								ADDRESS:		DATE:	