

REPUBLIC OF THE PHILIPPINES
DEPARTMENT OF PUBLIC WORKS & HIGHWAYS
OFFICE OF THE BUILDING OFFICIAL



CEBU CITY

RECOMMENDING APPROVAL:

HEAD, ARCHITECTURAL SECTIONDATE:

APPROVED:

BUILDING OFFICIALDATE:

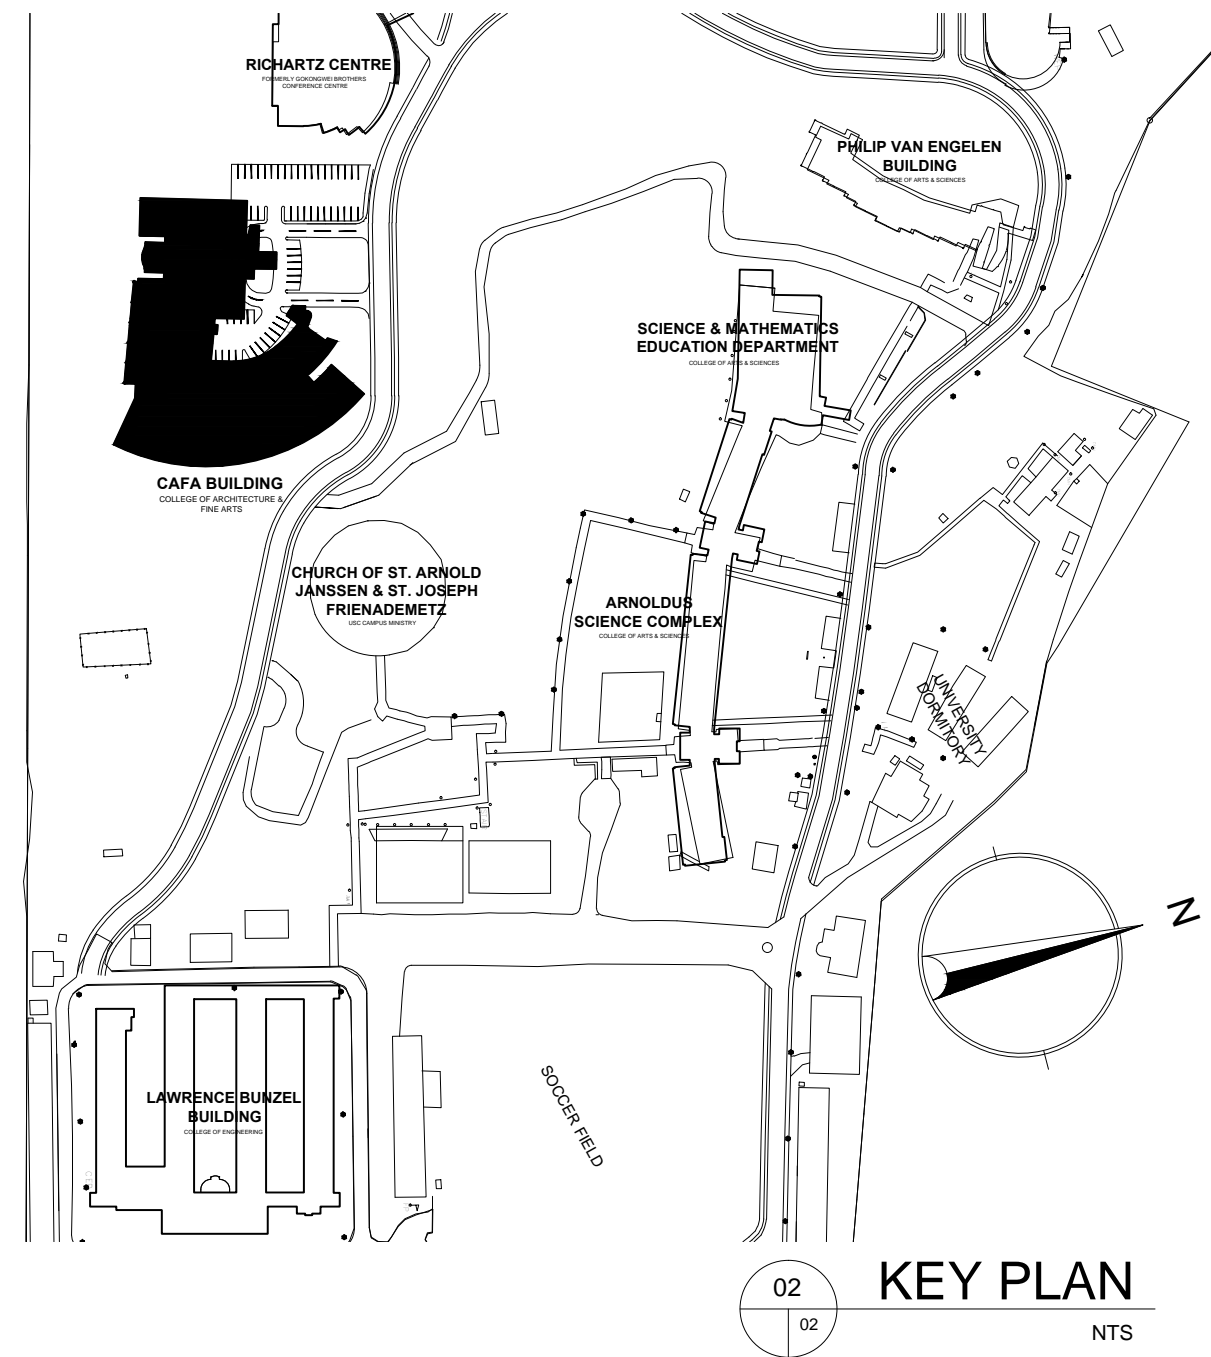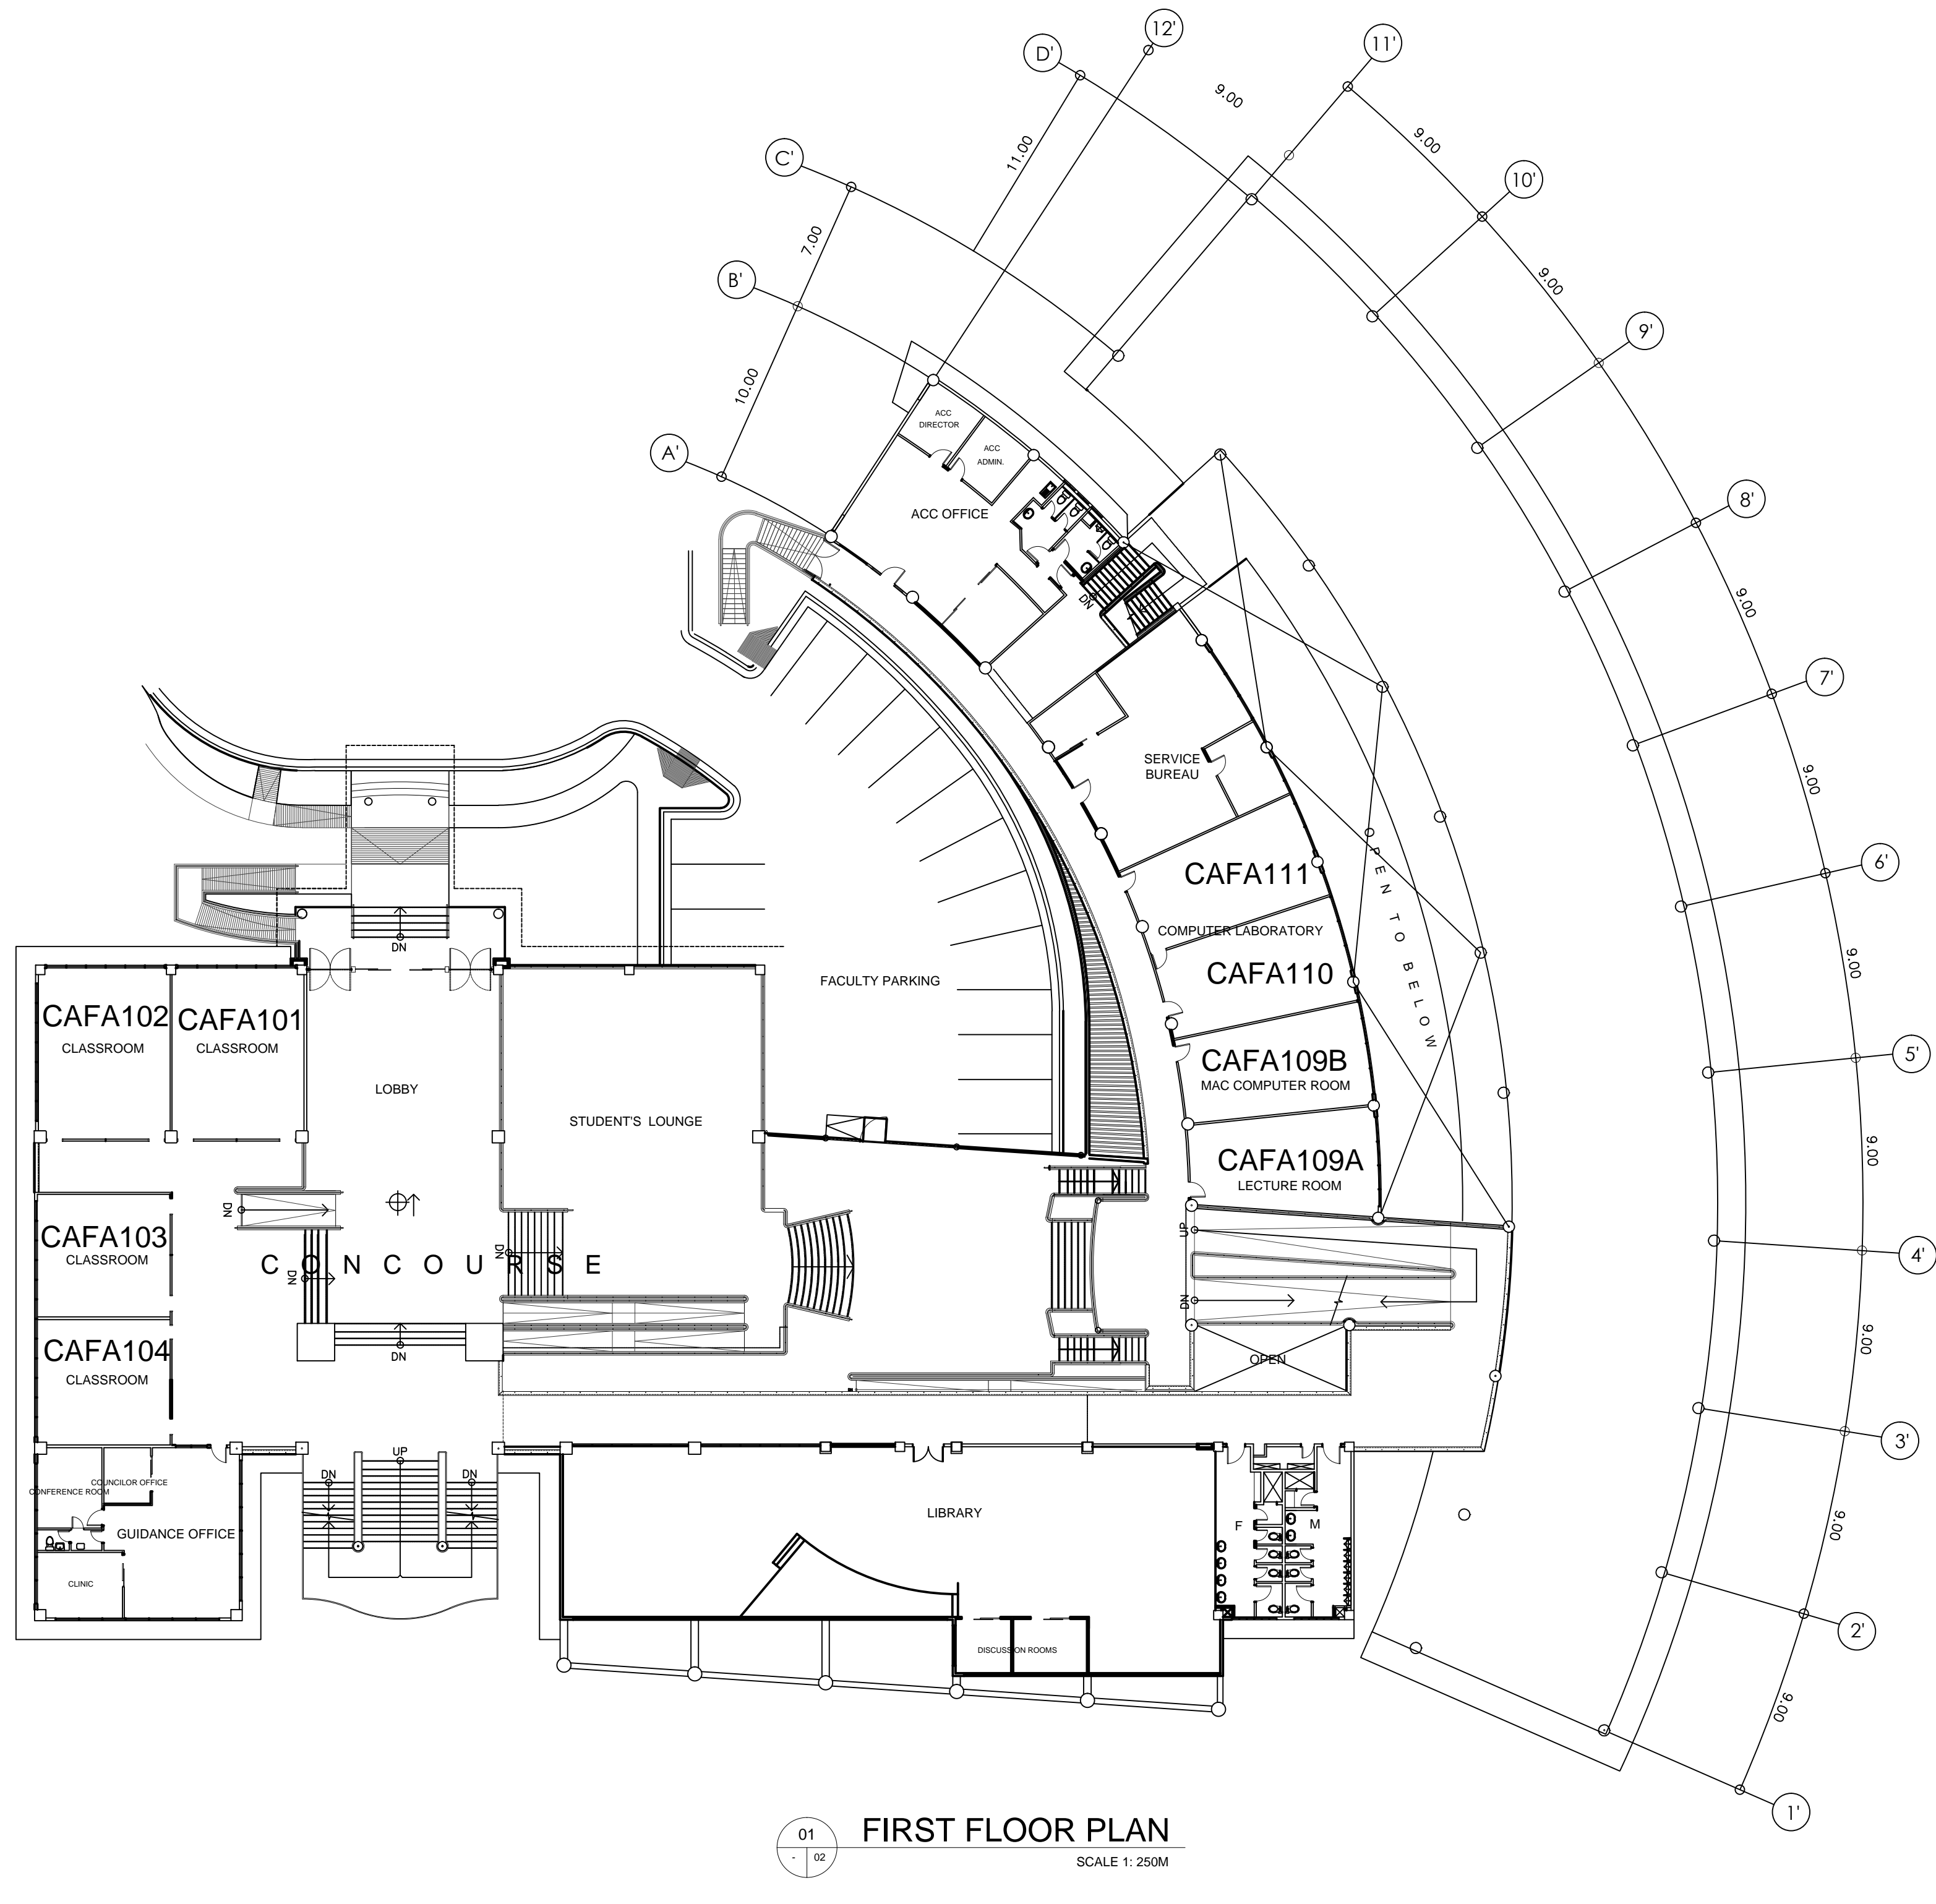

01
- 02
FIRST FLOOR PLAN
SCALE 1: 250M

02
- 02
KEY PLAN
NTS



ELLIS A. PUERTO
ARCHITECT

PRC NO. :	VALIDITY :
IAPOA NO. :	O.R. NO. : DATE:
PTR NO. :	DATE :
PLACE :	TIN :

R.A. 9266 ARTICLE IV SEC. 33
DRAWINGS AND SPECIFICATIONS AND OTHER CONTRACT DOCUMENTS DULY SIGNED, STAMPED OR SEALED, AS INSTRUMENTS OF SERVICE, ARE THE INTELLECTUAL PROPERTY AND DOCUMENTS OF THE ARCHITECT, WHETHER THE OBJECT FOR WHICH THEY ARE MADE IS EXECUTED OR NOT. IT SHALL BE UNLAWFUL FOR ANY PERSON TO DUPLICATE OR TO MAKE COPIES OF SAID DOCUMENTS FOR USE IN THE REPEITION OF AND FOR OTHER PROJECTS OR BUILDINGS, WHETHER EXECUTED PARTLY OR IN WHOLE, WITHOUT THE WRITTEN CONSENT OF ARCHITECT OR AUTHOR OF SAID DOCUMENTS.

PROJECT TITLE:	AS BUILT PLANS OF COLLEGE OF ARCHITECTURE AND FINE ARTS BUILDING
OWNER:	UNIVERSITY OF SAN CARLOS
LOCATION:	NASIPIT TALAMBAN, CEBU CITY

SHEET CONTENTS
01 AS SHOWN
ENCODED BY: VILLANUEVA, IL JEAN R.
REVISED BY:

REVISIONS
1
2
3

APPROVED:
FR. DIONISIO M. MIRANDA, SVD P R E S I D E N T
ADDRESS:

CONTRACT DRAWING NO.
A-000 A-000
DATE: